

ANNOTATED MARKED UP DRAWINGS
PROPOSED DRAWING AMENDMENTS


FOR SN 10/813,436

Council of Scientific & Industrial Research

Sheet No.

Patent Application No.

No. of Sheets:

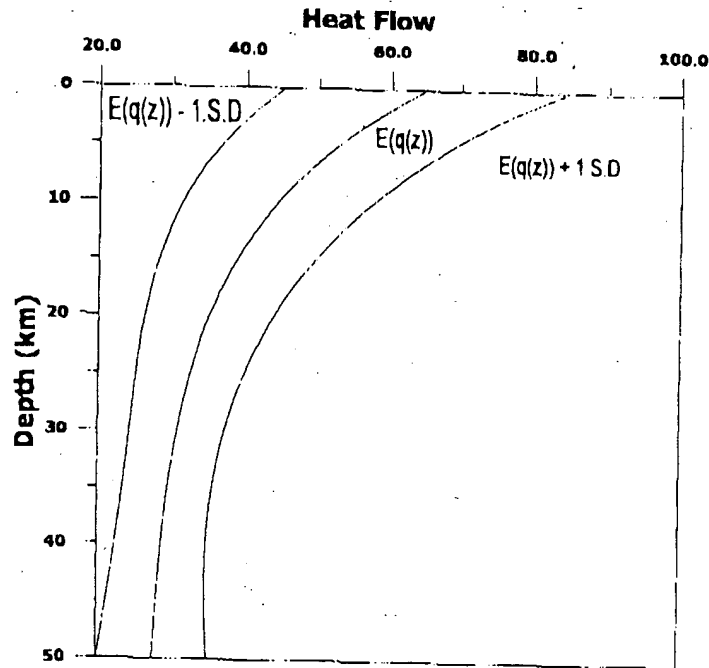

APPLICANTS

Fig 1.

ANNOTATED MARKED UP DRAWINGS
PROPOSED DRAWING AMENDMENT


FOR SN 10/813,436

Council of Scientific & Industrial Research

Patent Application No.

Sheet No.

No. of Sheets

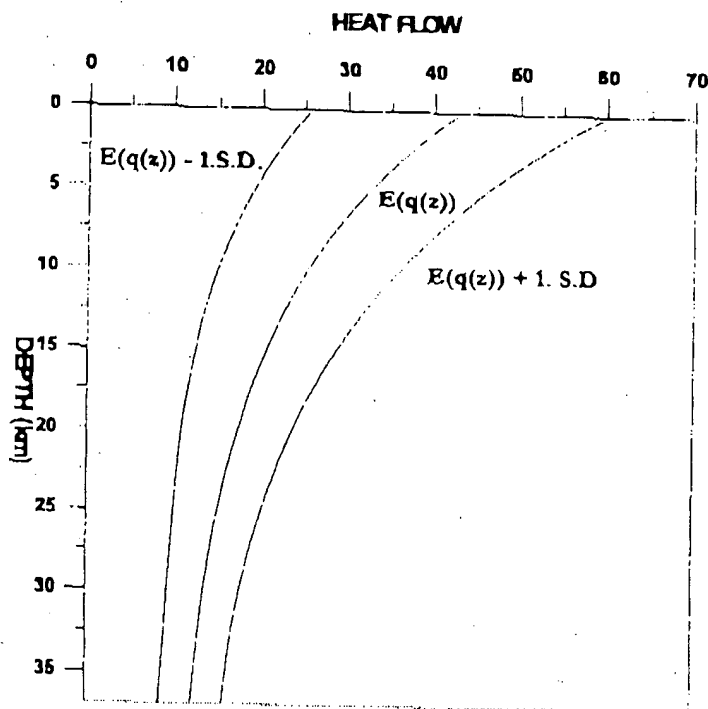

APPLICANTS

Fig 2

ANNOTATED MARKED UP DRAWINGS
PROPOSED DRAWING AMENDMENTS

FOR SN 10/813,436

FLOW CHART OF THE PROCEDURE

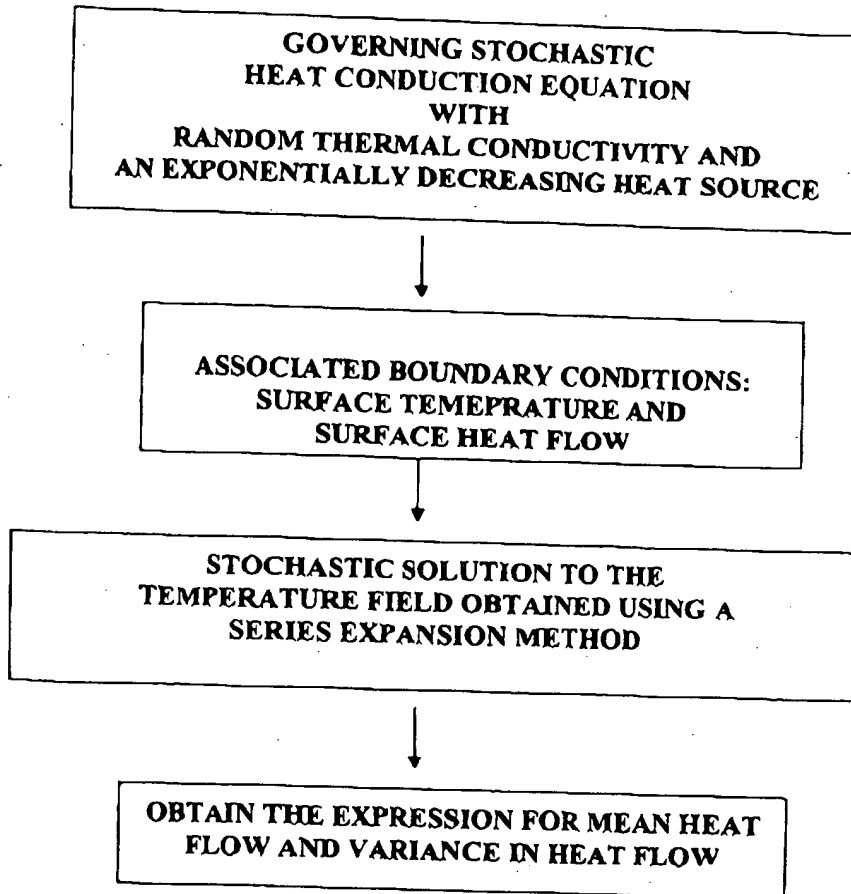


FIG. 3